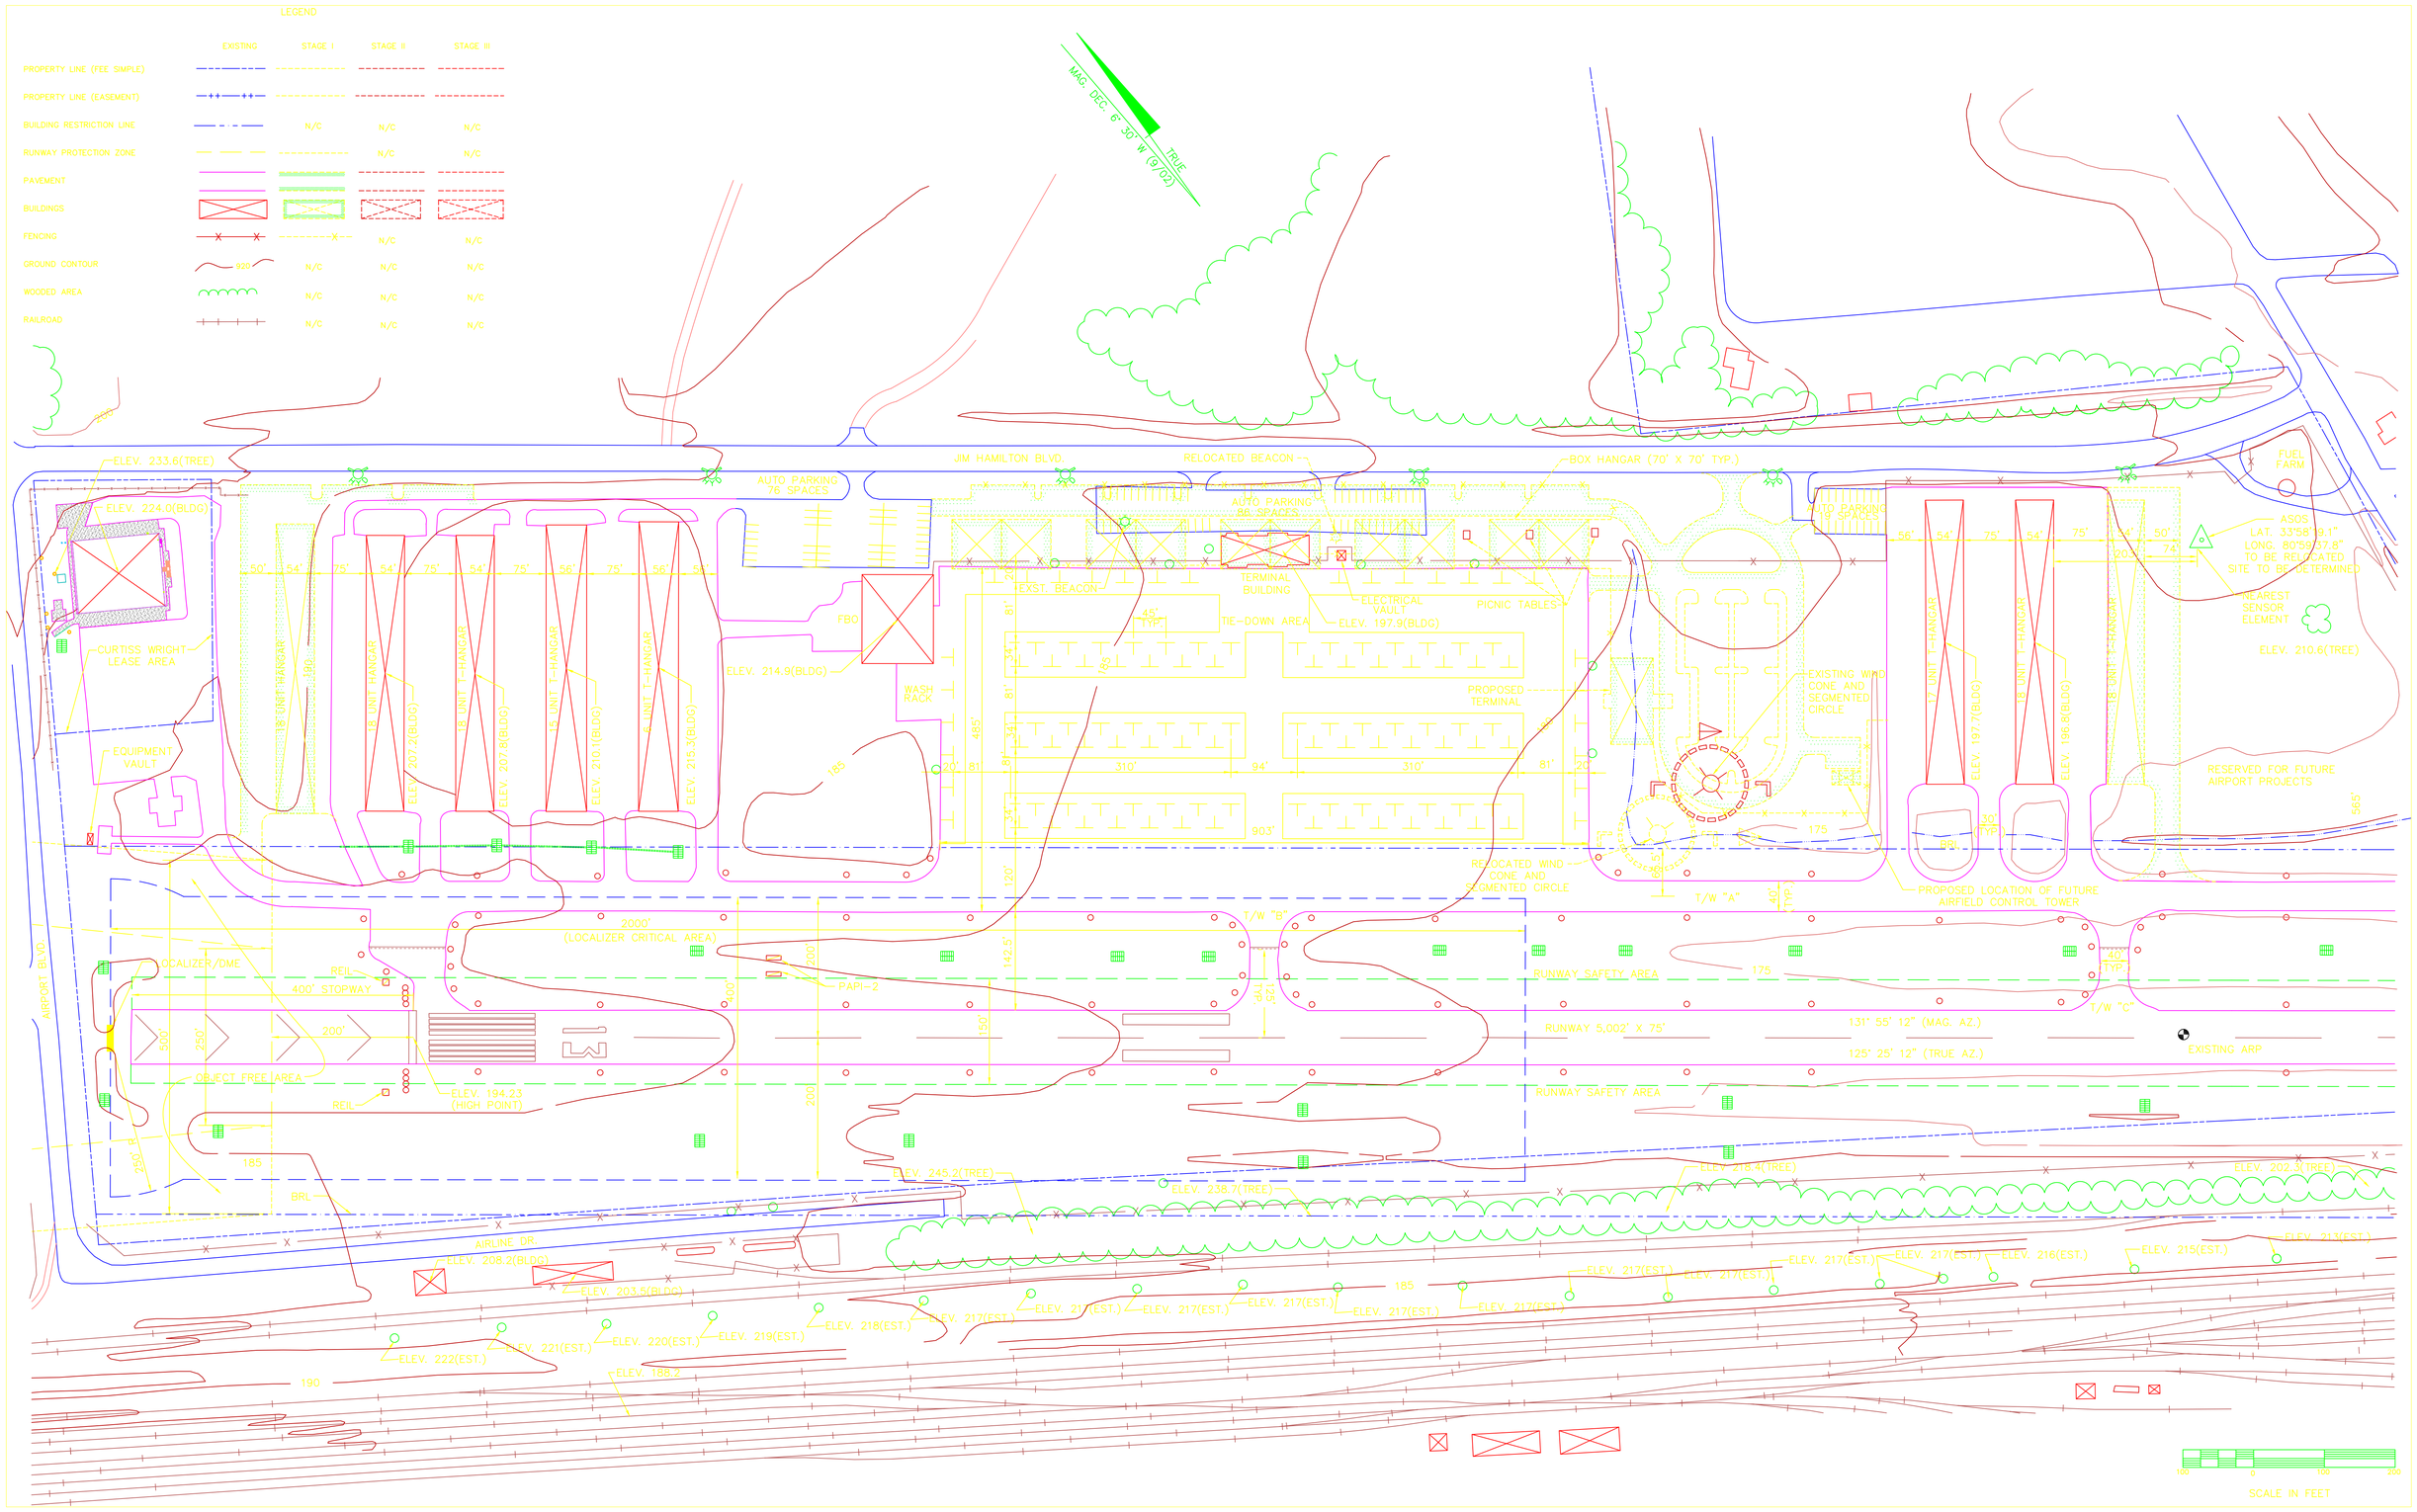

REV. NO.	DESCRIPTION	DATE
1	ASBUILT OF DRAINAGE, AWOS, VAULTS, PROPOSED TERMINAL DEVELOPMENT AREA & CURTISS WRIGHT LEASE AREA	9/23/02

REVISIONS

PROJECT MANAGER: GAV
DRAWN BY: TEE/RBT
PLOTTED BY: SEW
FILE NAME: TAP
DRAWING SCALE: 1" = 100'
PROJECT DATE: 9/91
PROJECT NUMBER: 20438.00.CA
PLOT DATE:

WK DICKSON
Engineers • Planners • Surveyors
Landscape Architects

501 COMMERCE DRIVE NE
COLUMBIA, SC 29223
(803) 786-4261

Asheville, NC
Atlanta, GA
Charlotte, NC
Columbia, SC
Hickory, NC
Raleigh, NC
Wilmington, NC

RELEASED FOR	DATE
APPROVALS	
BIDDING	
CONSTRUCTION	
RECORD DWG.	

2002

COLUMBIA OWENS DOWNTOWN AIRPORT
RICHLAND COUNTY COUNCIL
COLUMBIA, SOUTH CAROLINA

TERMINAL AREA PLAN

3/7

D-4026